

**SECTION 000001 – ADDENDUM NUMBER 2**

**DATE: DECEMBER 8, 2025**

**TO: ALL BIDDERS**

**FROM: WESTON & SAMPSON ENGINEERING, INC,  
427 MAIN STREET, SUITE 400  
WORCESTER, MA 01608**

**RE: DCU CENTER ELEVATOR RENOVATION  
50 FOSTER STREET, WORCESTER, MA 01608**

**THIS ADDENDUM FORMS A PART OF THE CONTRACT AND MODIFIES THE ORIGINAL DOCUMENTS DATED NOVEMBER 2025.**

**PART 1 - GENERAL**

- 1.1** This addendum must be returned with plans and specifications (if not already returned) to have your deposit returned.
- 1.2** This addendum modifies, amends, and supplements the Contract Documents for the above referenced project. This addendum is hereby made a part of the Contract Documents by reference and shall be as binding as though inserted in locations designated hereunder.
- 1.3** Each general bidder shall be responsible for notifying all his non-filed sub-bidders and suppliers of the content of this addendum. No claim for additional compensation will be considered because of lack of knowledge of changes or modifications contained in this addenda.
- 1.4** Questions or requests for clarification shall be in writing, addressed to Jeremy C. Flansburg SPECIAL PROJECT COORDINATOR, City Hall-Purchasing Division, OF PURCHASING, 455 Main St room 201, Worcester, MA 01608 or email [flansburgj@worcesterma.gov](mailto:flansburgj@worcesterma.gov). Please include your name, phone number, and e-mail.
- 1.5** Part 2 of this addendum indicates revisions to the Project Manual.
- 1.6** Part 3 of this addendum indicates revisions to the Drawings.
- 1.7** Part 4 of this addendum indicates clarification to Contractors Questions.

**PART 2 - SPECIFICATION – NONE**

**PART 3 - DRAWINGS**

**3.1** Replace the following Drawings in their entirety with the versions attached to this addendum.

- A. A101 – FLOOR PLANS & ELEVATIONS
- B. A201 – SECTIONS, PARTITION DOOR TYPES
- C. H101 – FIRST FLOOR AND ROOF PART PLANS
- D. H601 – DETAILS AND AUTOMATIC TEMPERATURE CONTROLS

**PART 4 - CONTRACTOR QUESTIONS**

**4.1** **Question:** Details 1 & 2 On A201 shows the route of travel for the new lines for the MEP equipment up to the roof. Please provide scope of work as to how we access the wall cavity space and then close it up.  
**Response:** New lines will be routed through the Storage Room and daylight on the flat EPDM roof and terminated on a pitch pocket. Please refer to attached reissued drawings.






**4.2** **Question:** Detail 5 on A201 shows a pitch pocket. Is a pitch pocket needed or can all piping and or conduit go through the vertical wall that equipment is proposed to be mounted on?  
**Response:** Yes, pitch pocket will be used at new MEP equipment lines penetrating the storage room roof.

**4.3** **Question:** Detail 3 on H101 shows mounting the ACCU's on wall support brackets. Please provide scope of work needed to prepare an adequate support surface to mount on.  
**Response:** ACCU's to be mounted on prefabricated stand 18" high above roof membrane. ACCU unit shall be bolted to supports to withstand wind and seismic loads. Please refer to attached reissued drawings.


**END OF ADDENDUM NUMBER 2**

REFLECTED CEILING PLAN LEGEND:


CEILING TYPES:	
TYPE G1: 2-HR FIRE RATED CEILING UL DESIGN NO. U415	
CEILING TAG	
LIGHT FIXTURES	
SURFACE MTD. LIGHT FIXTURE	
EXIT SIGN	
MOTION DETECTOR	
SMOKE DETECTOR	
OCCUPANCY SENSOR	
CEILING PHOTO SENSOR	
CEILING FLUSH MOUNTED SPEAKER	
FIRE ALARM SPEAKER / VISUAL SIGNAL	
CEILING MOUNTED FIRE ALARM SPEAKER / VISUAL SIGNAL	
FIRE ALARM VISUAL SIGNAL	

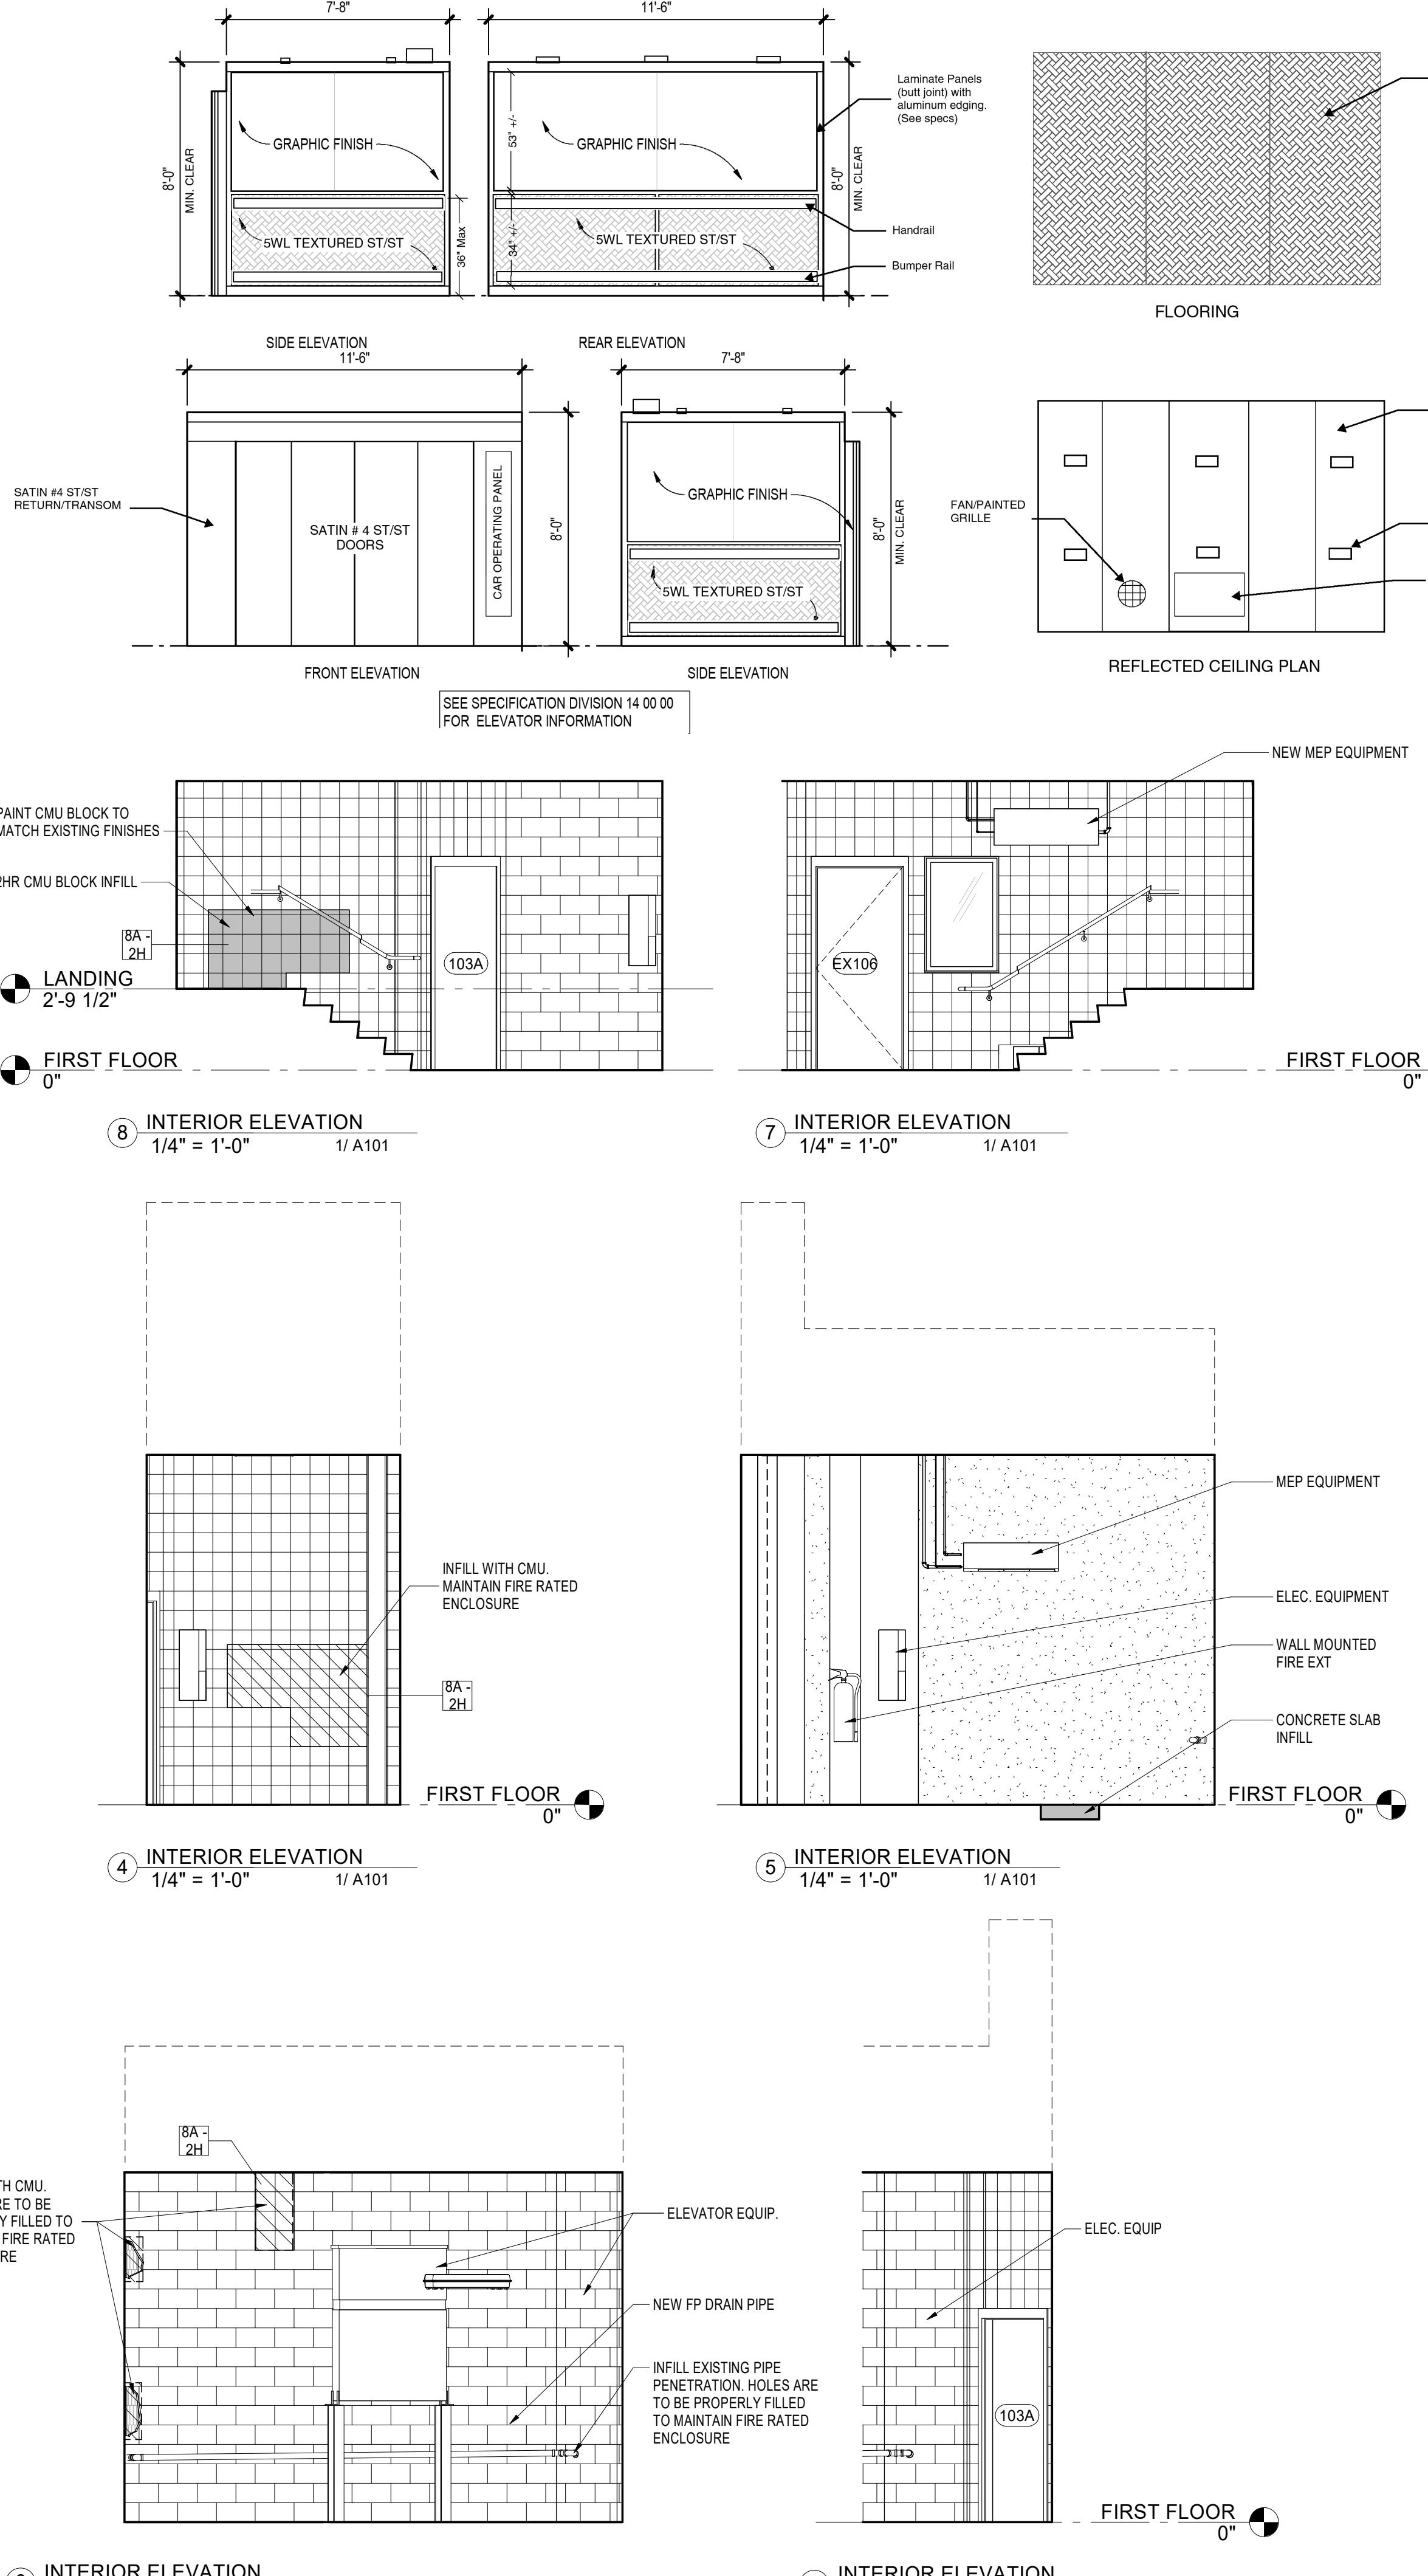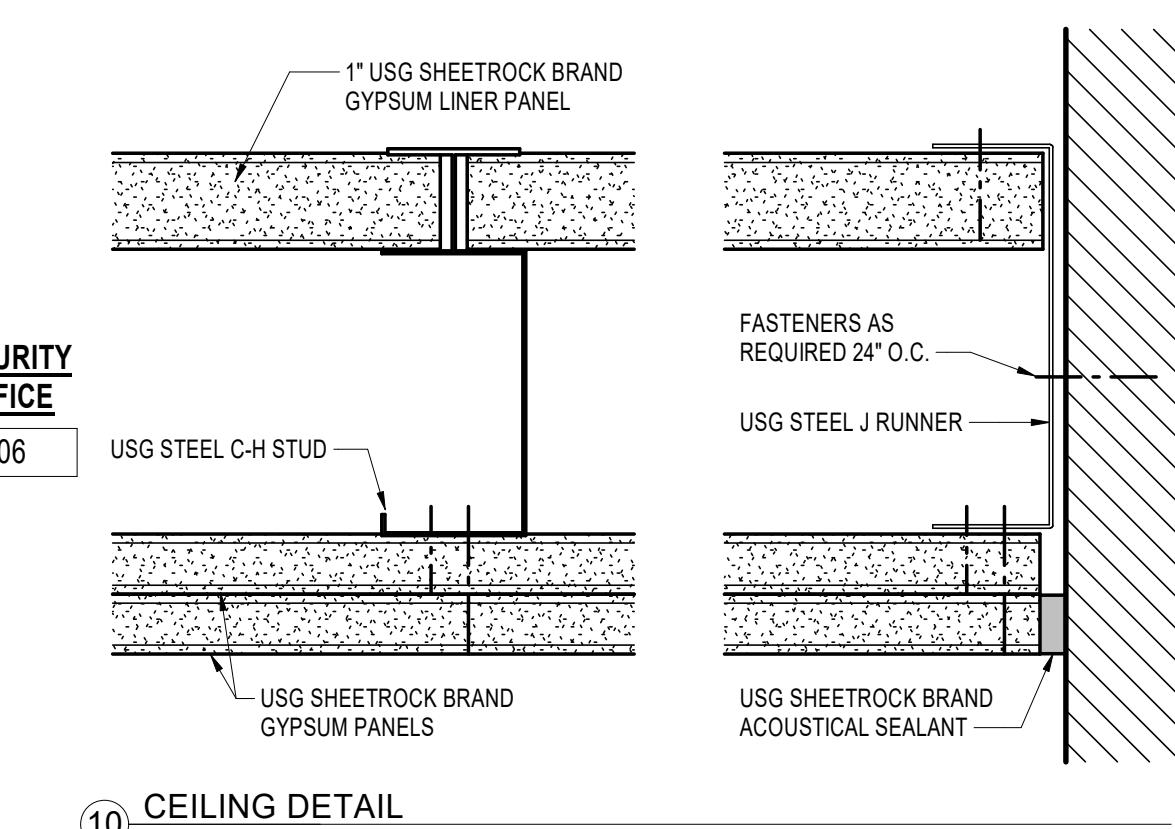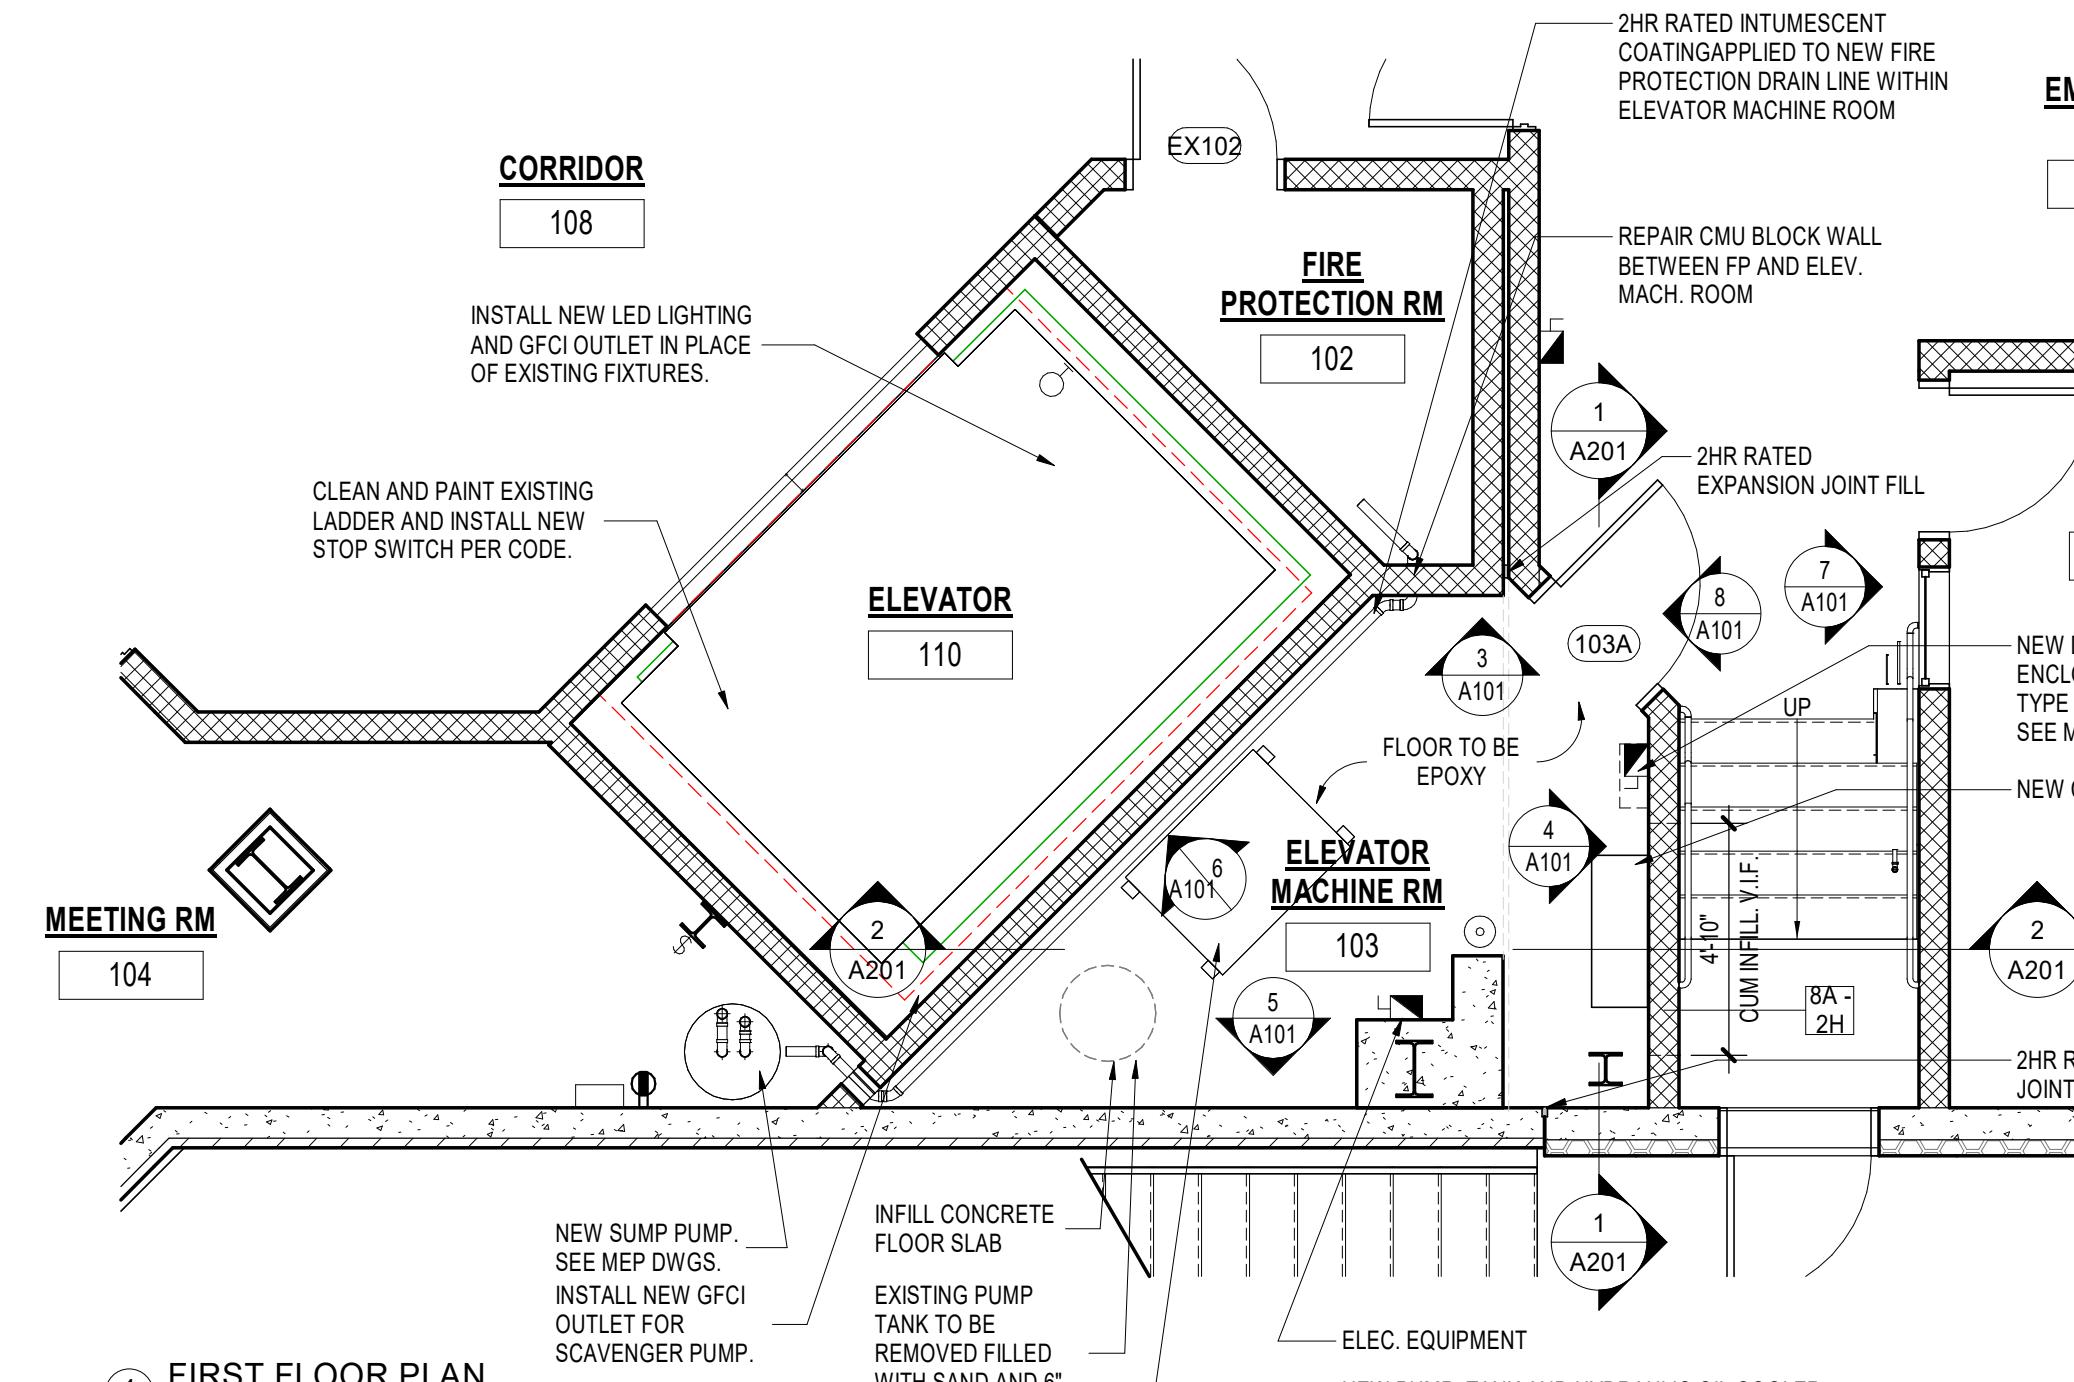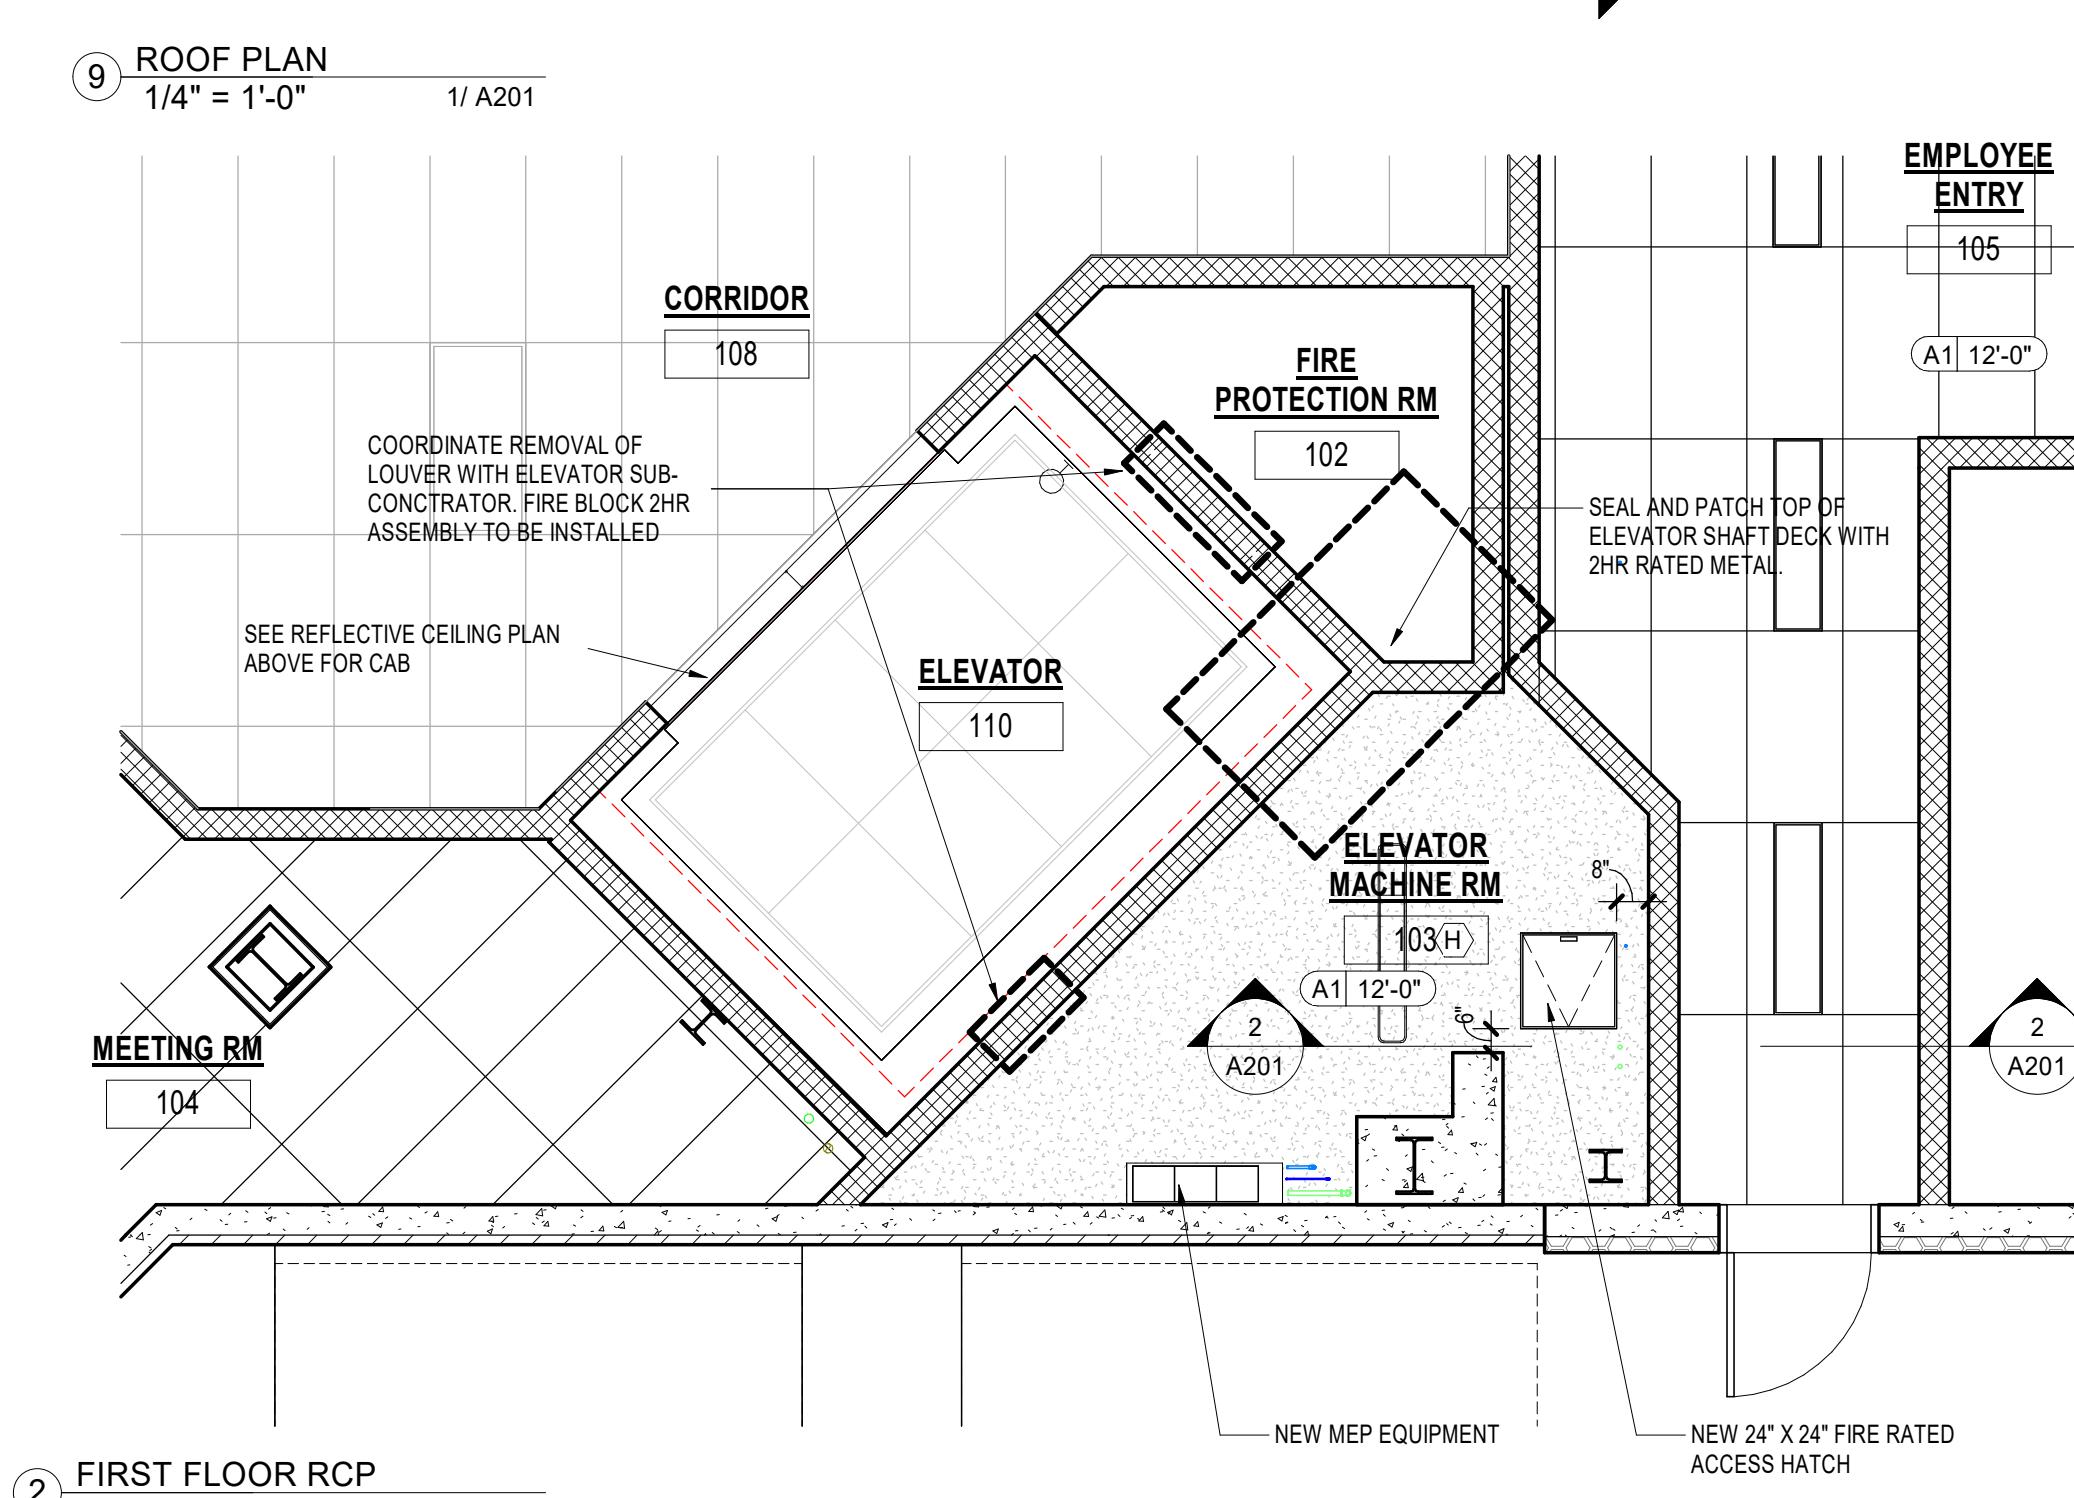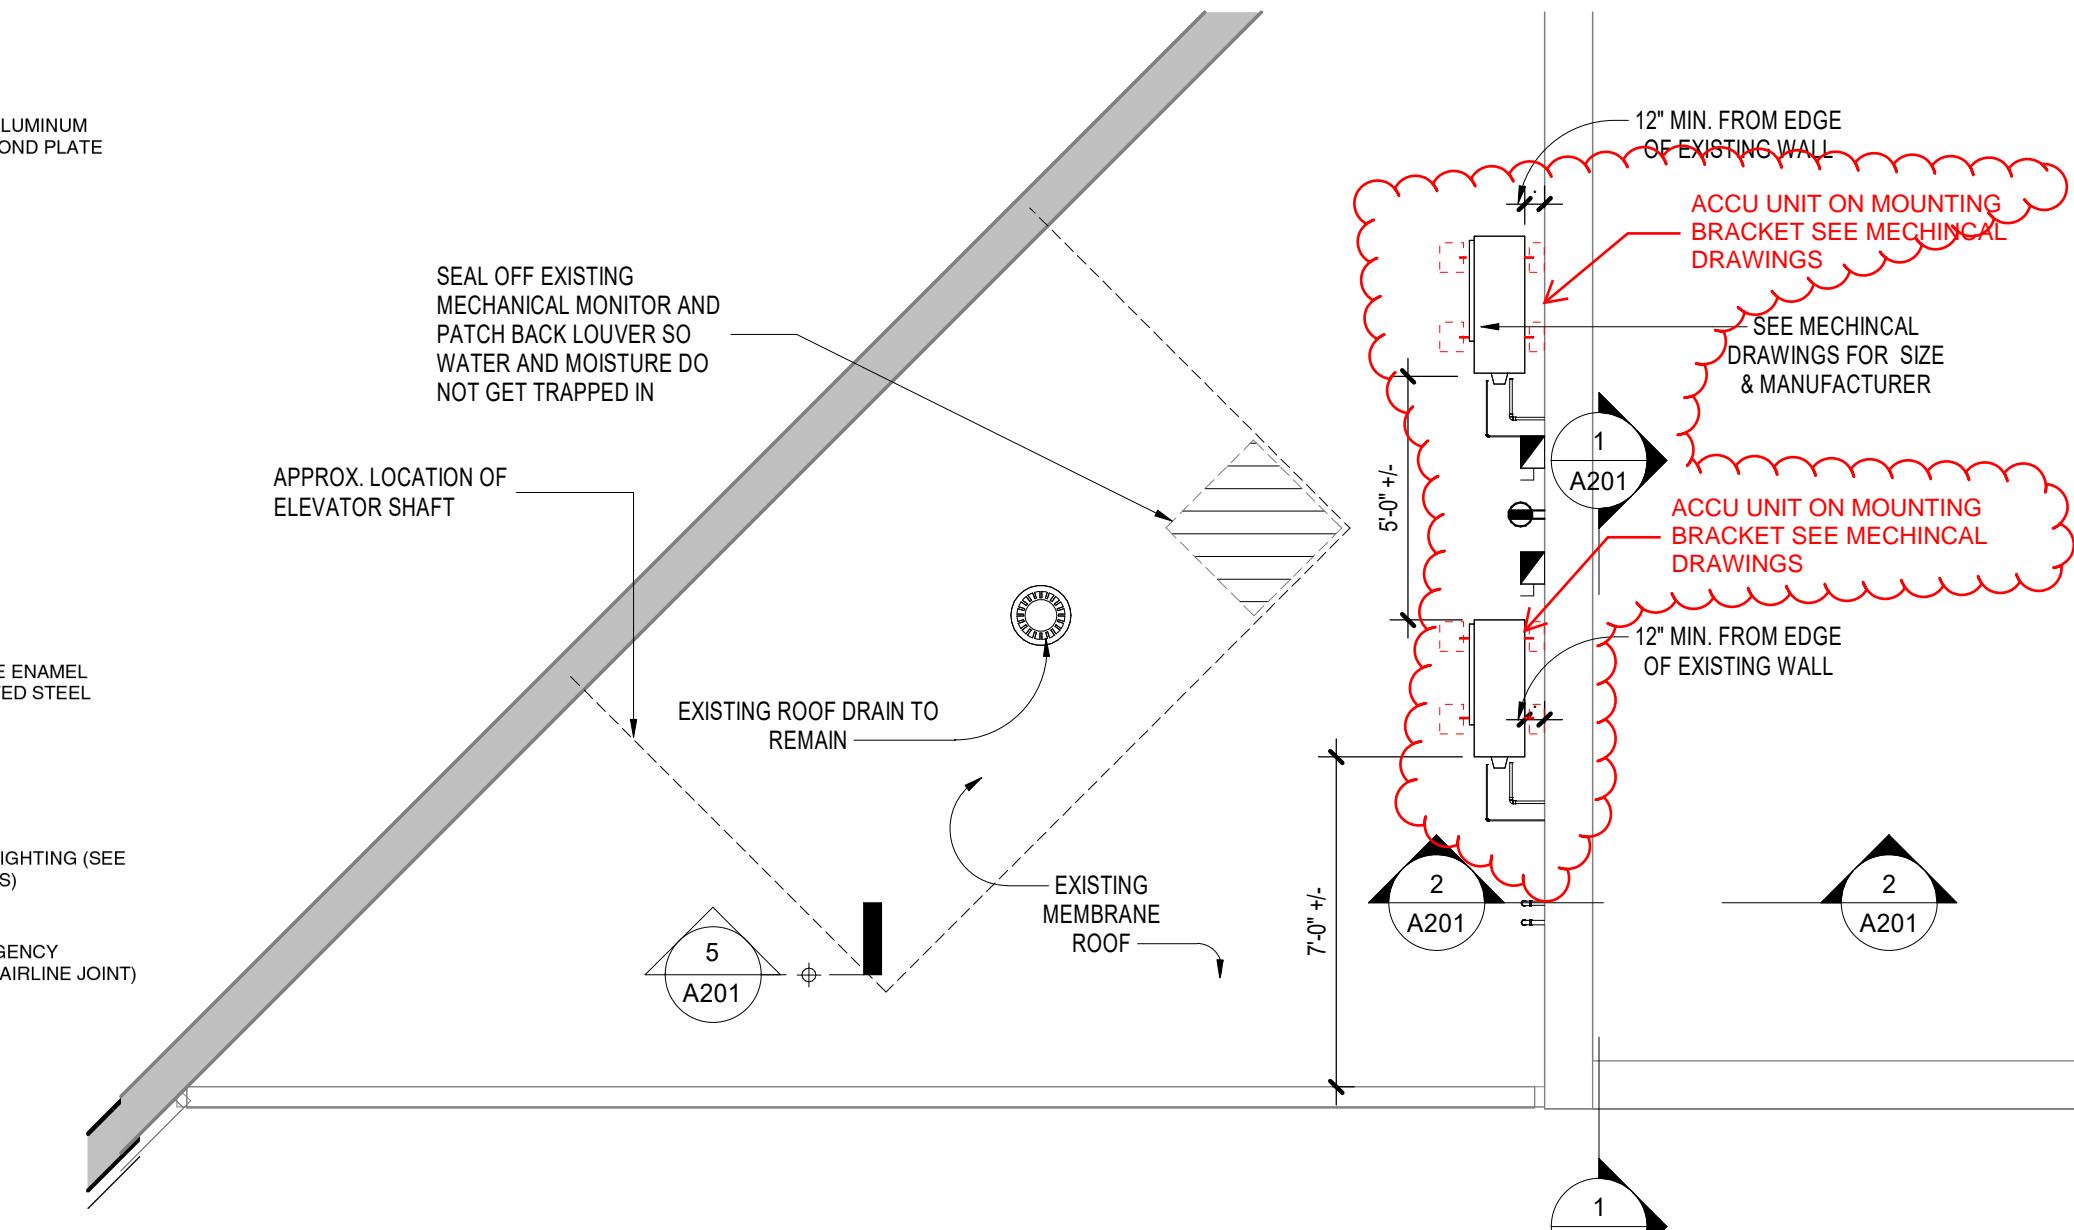



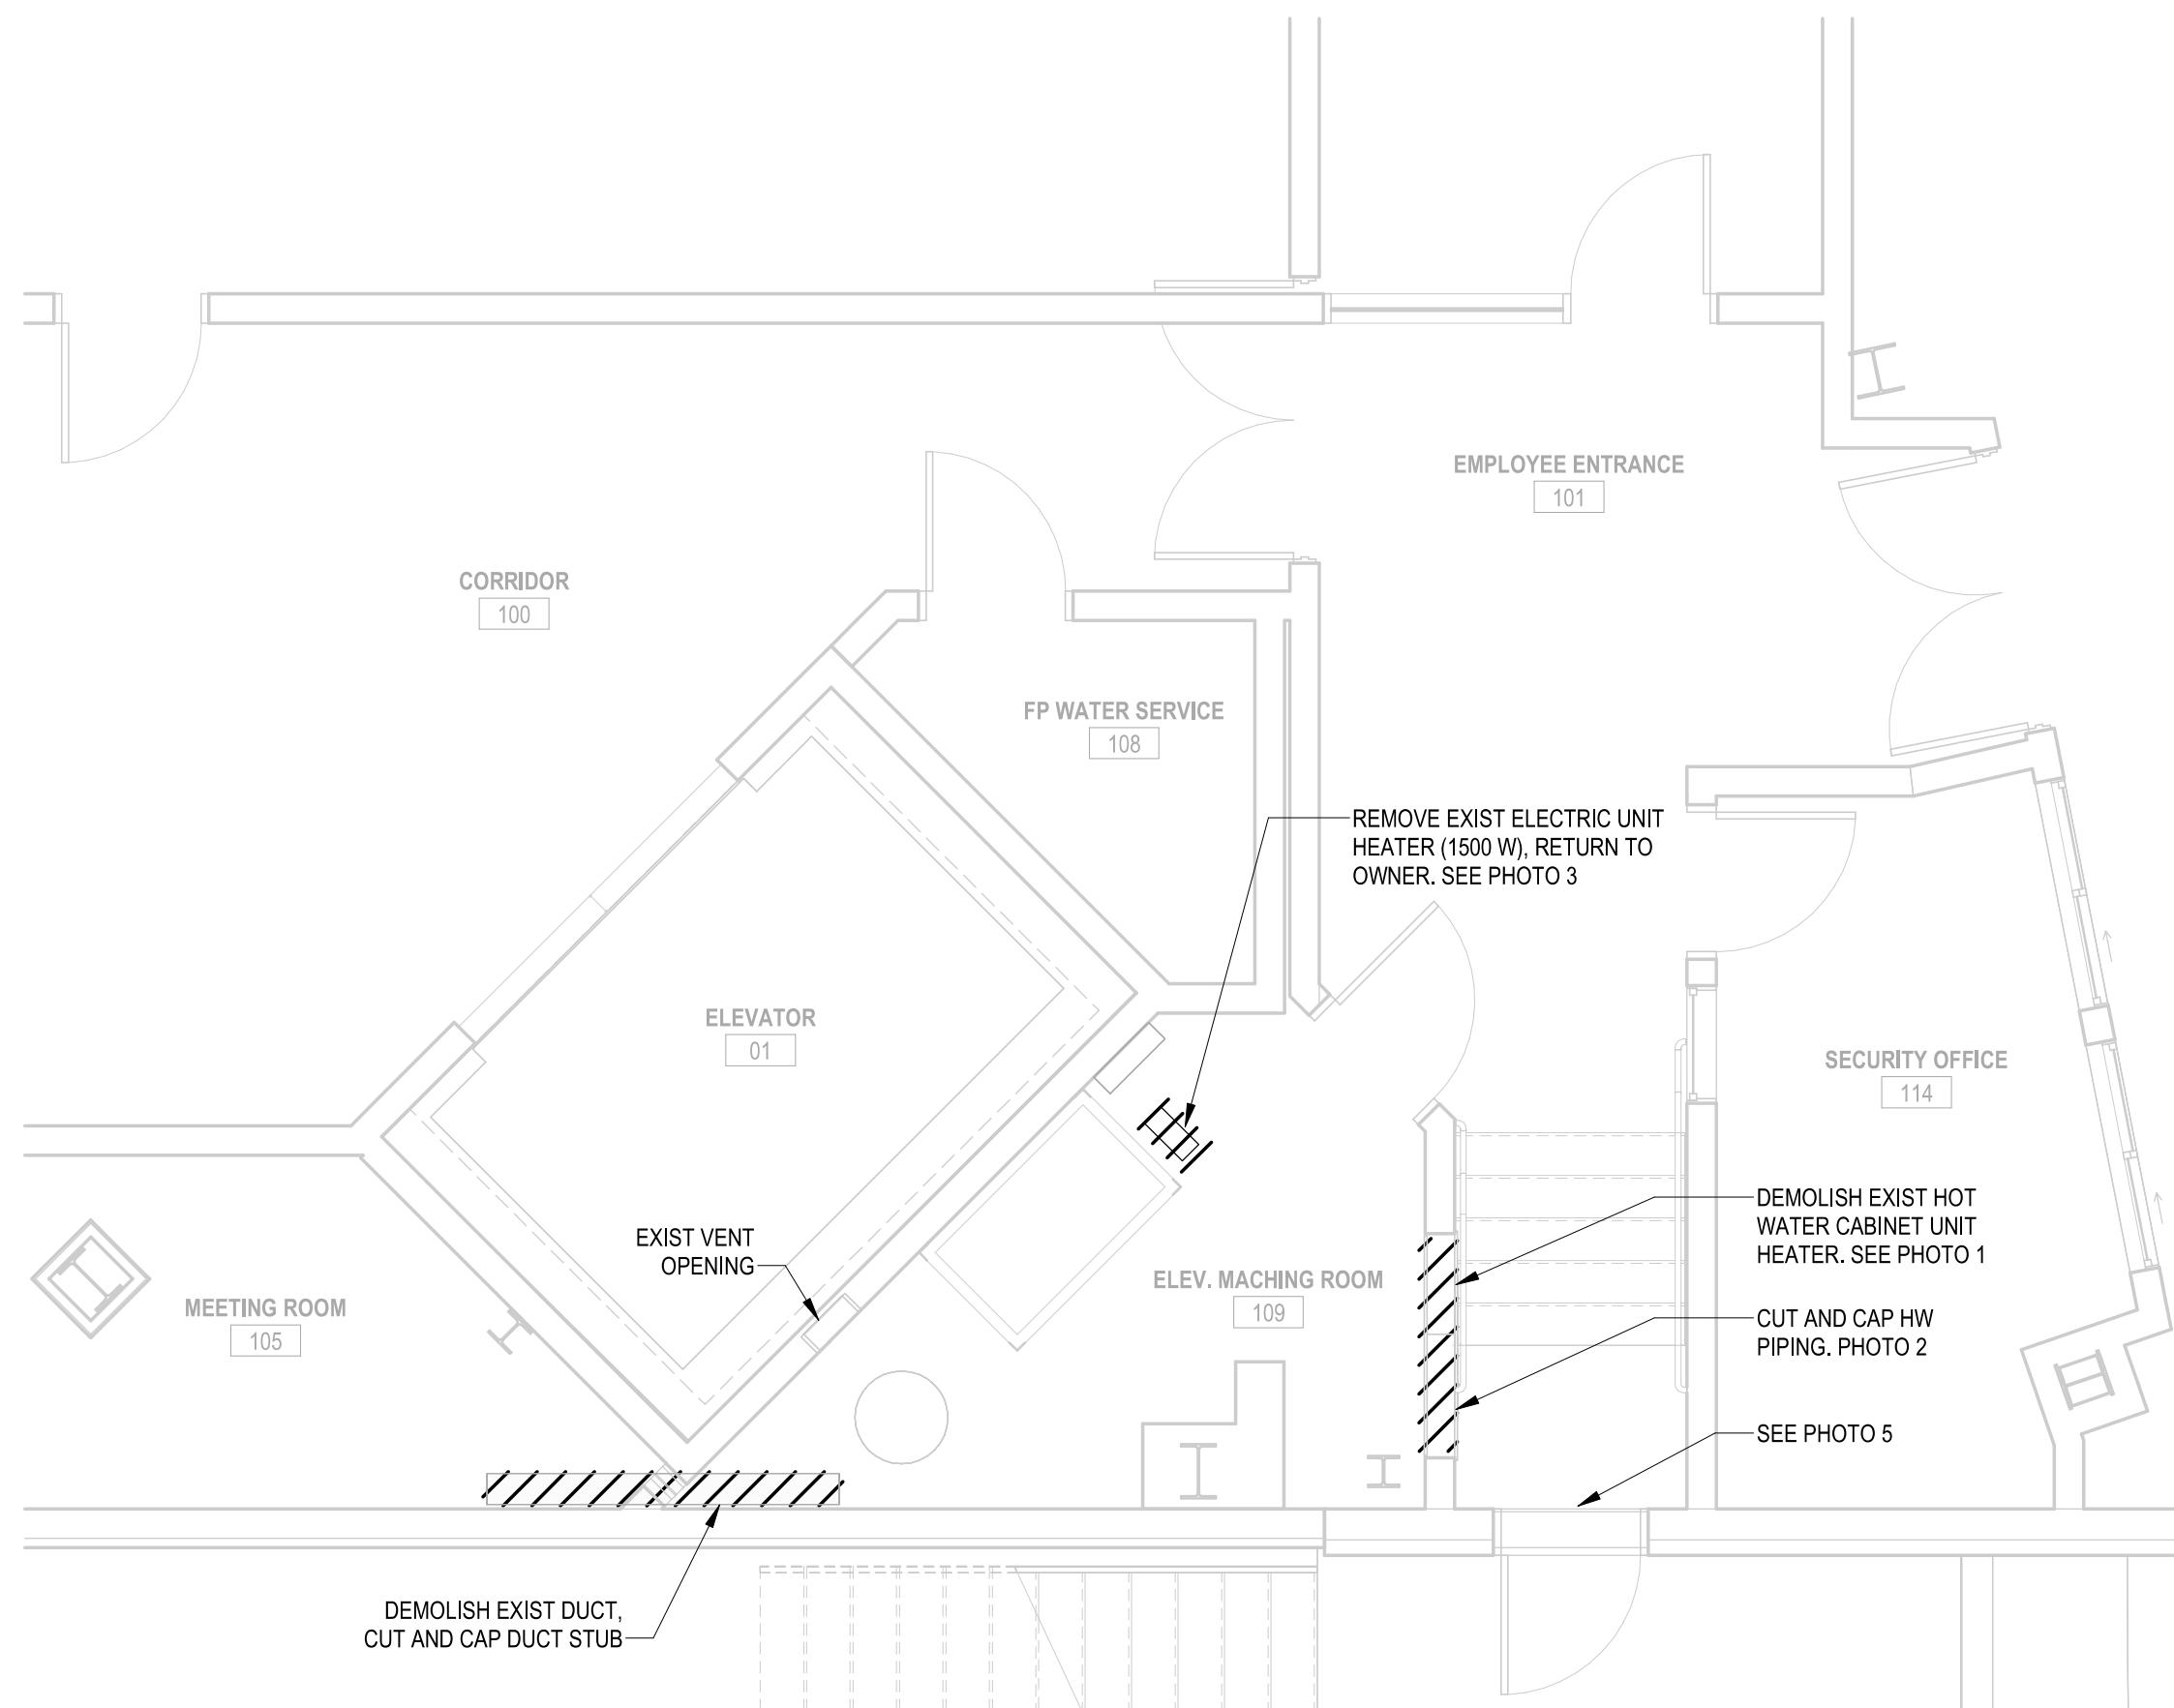

① DEMOLITION FLOOR PART PLAN - HVAC  
1/4" = 1'-0"

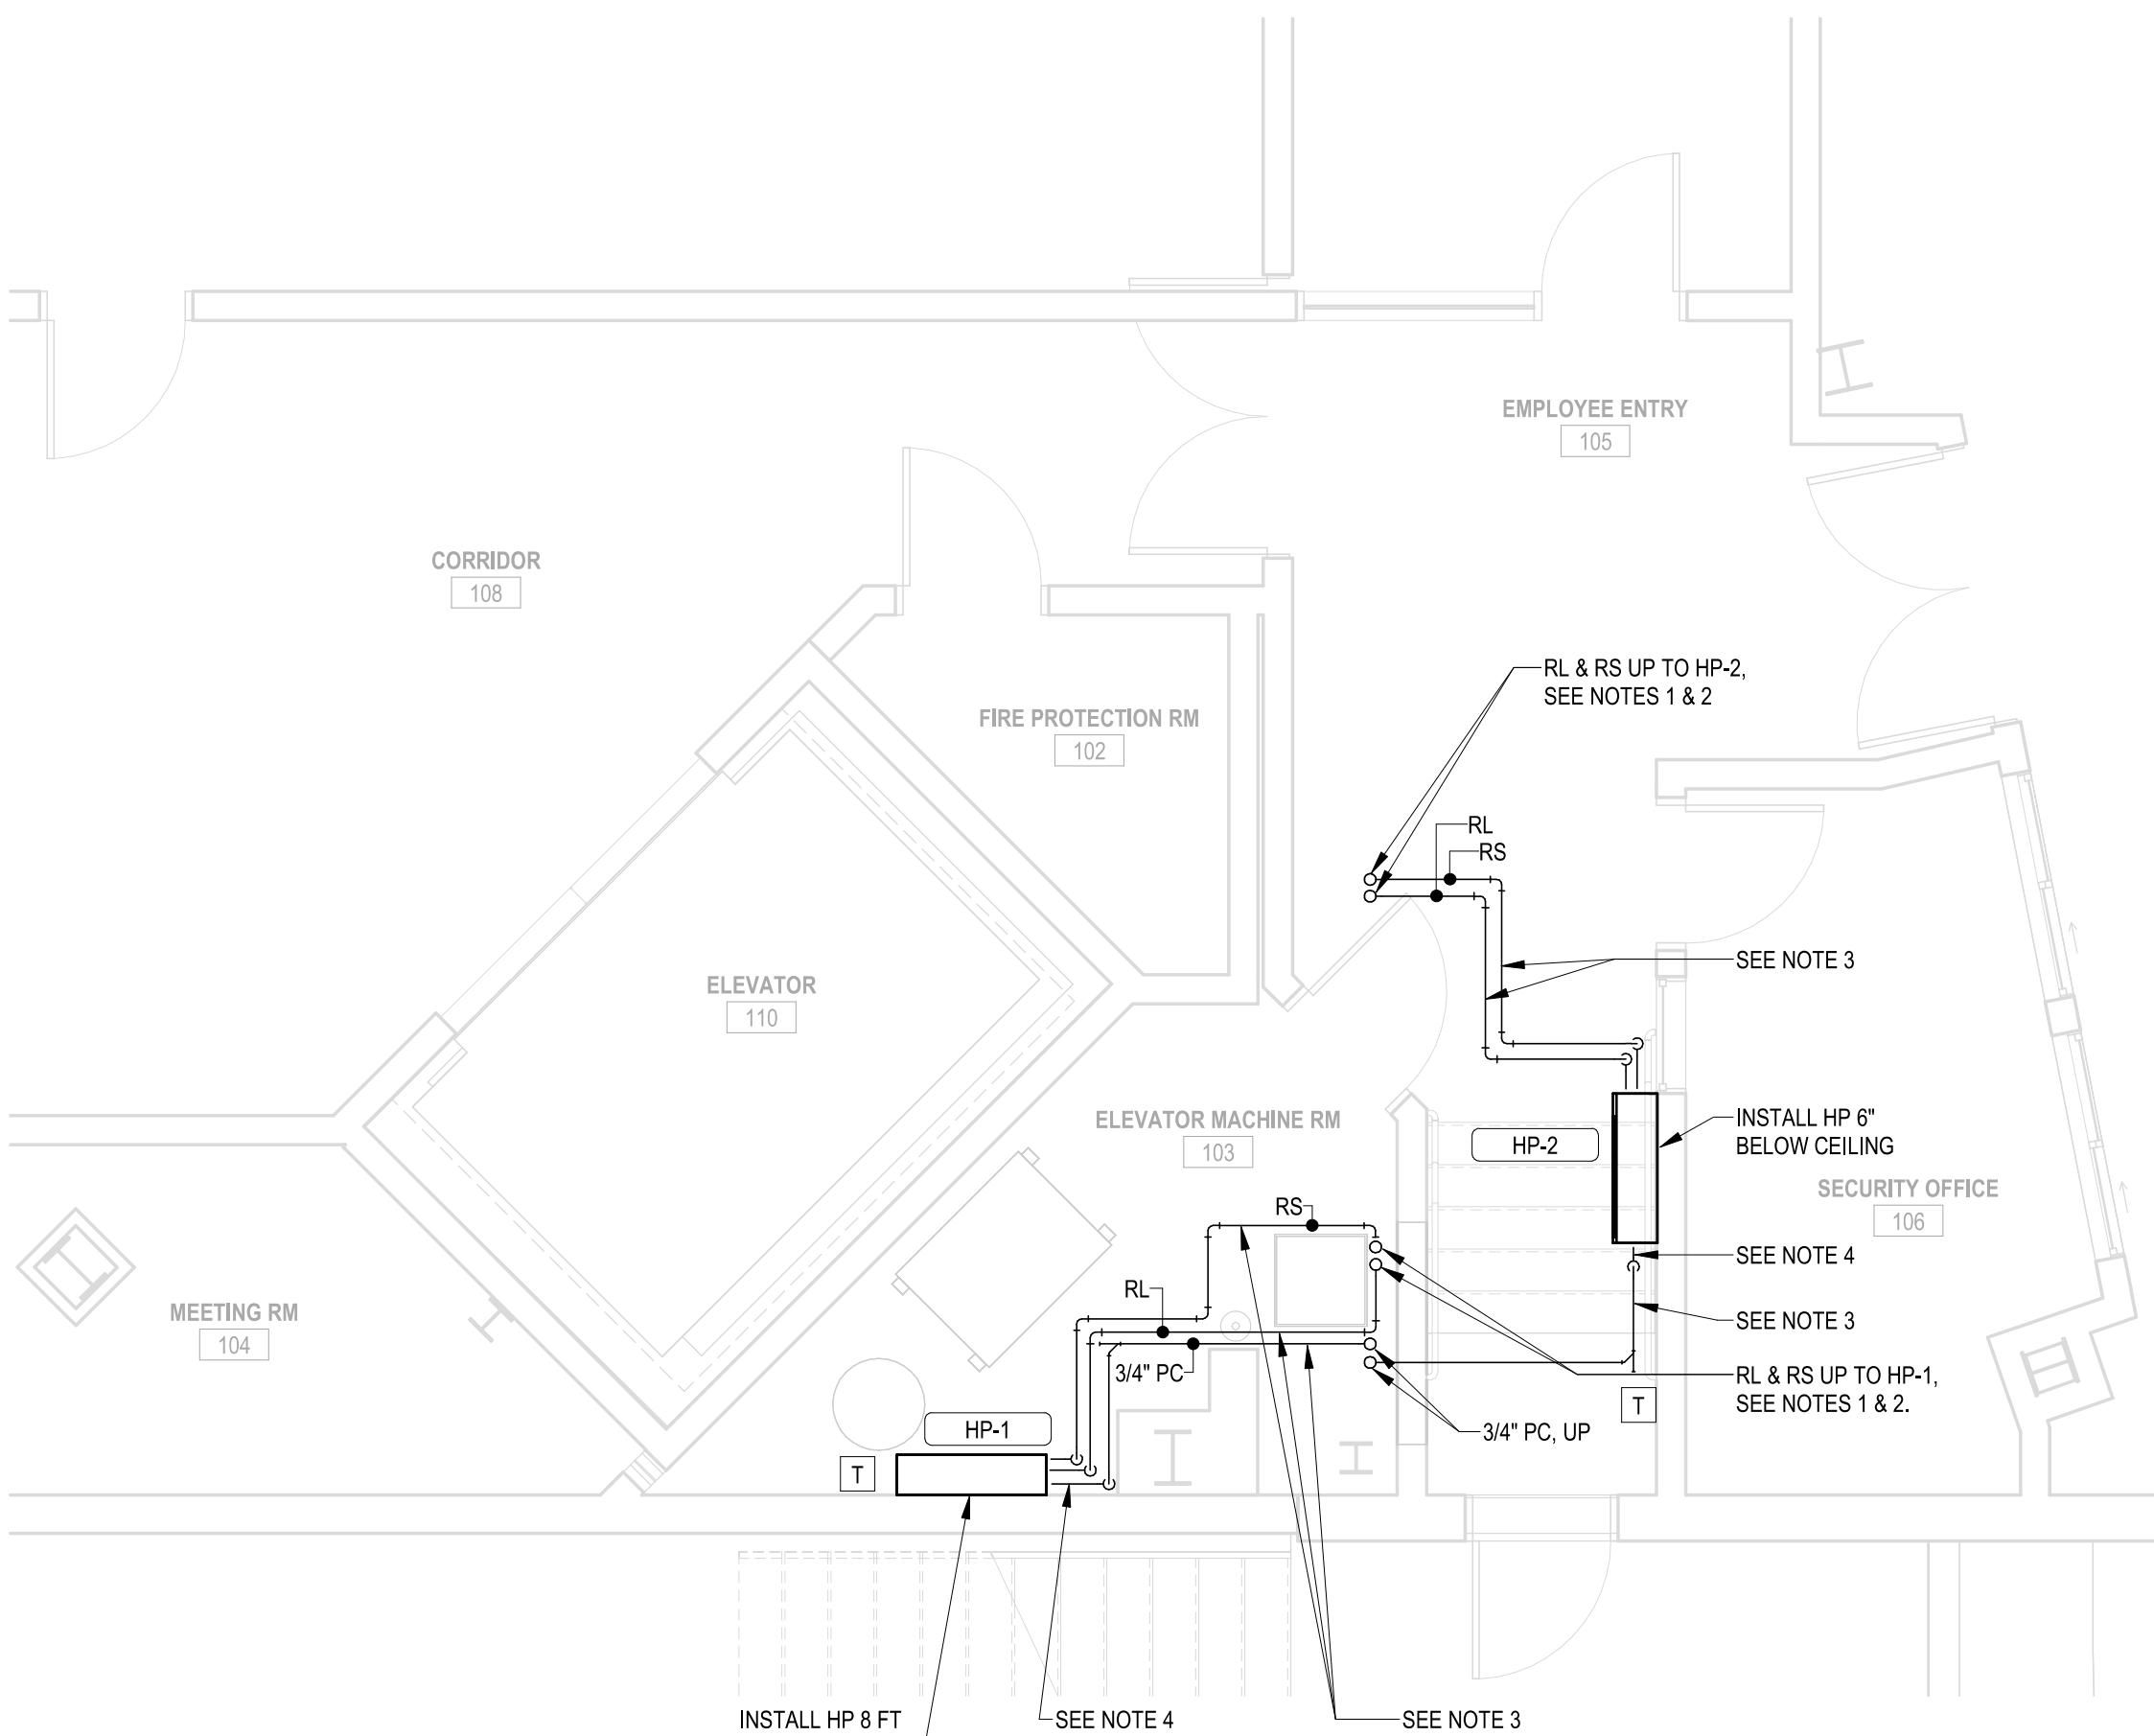


② FLOOR PART PLAN - HVAC  
1/4" = 1'-0"



NOTES:

1. REFRIGERANT PIPING SIZES SHALL BE PER DUCTLESS SPLIT SYSTEM MANUFACTURER.
2. REFRIGERANT PIPING TOTAL EQUIVALENT LENGTH SHALL NOT EXCEED DUCTLESS SPLIT SYSTEM MANUFACTURER'S RECOMMENDATIONS.
3. RUN RL, RS, AND PC PIPING ABOVE CEILING. COORDINATE PIPING WITH BUILDING EXISTING AND NEW CONDITIONS.
4. PROVIDE HP UNIT WITH CONDENSATE PUMP. RUN 3/4" PC PIPE ABOVE UP TO LOW ROOF.
5. PROVIDE MINIMUM SPACE AROUND UNITS AS REQUIRED BY THE MANUFACTURER. COORDINATE ACCU LOCATION WITH EXISTING ROOF AND WALL FEATURES.

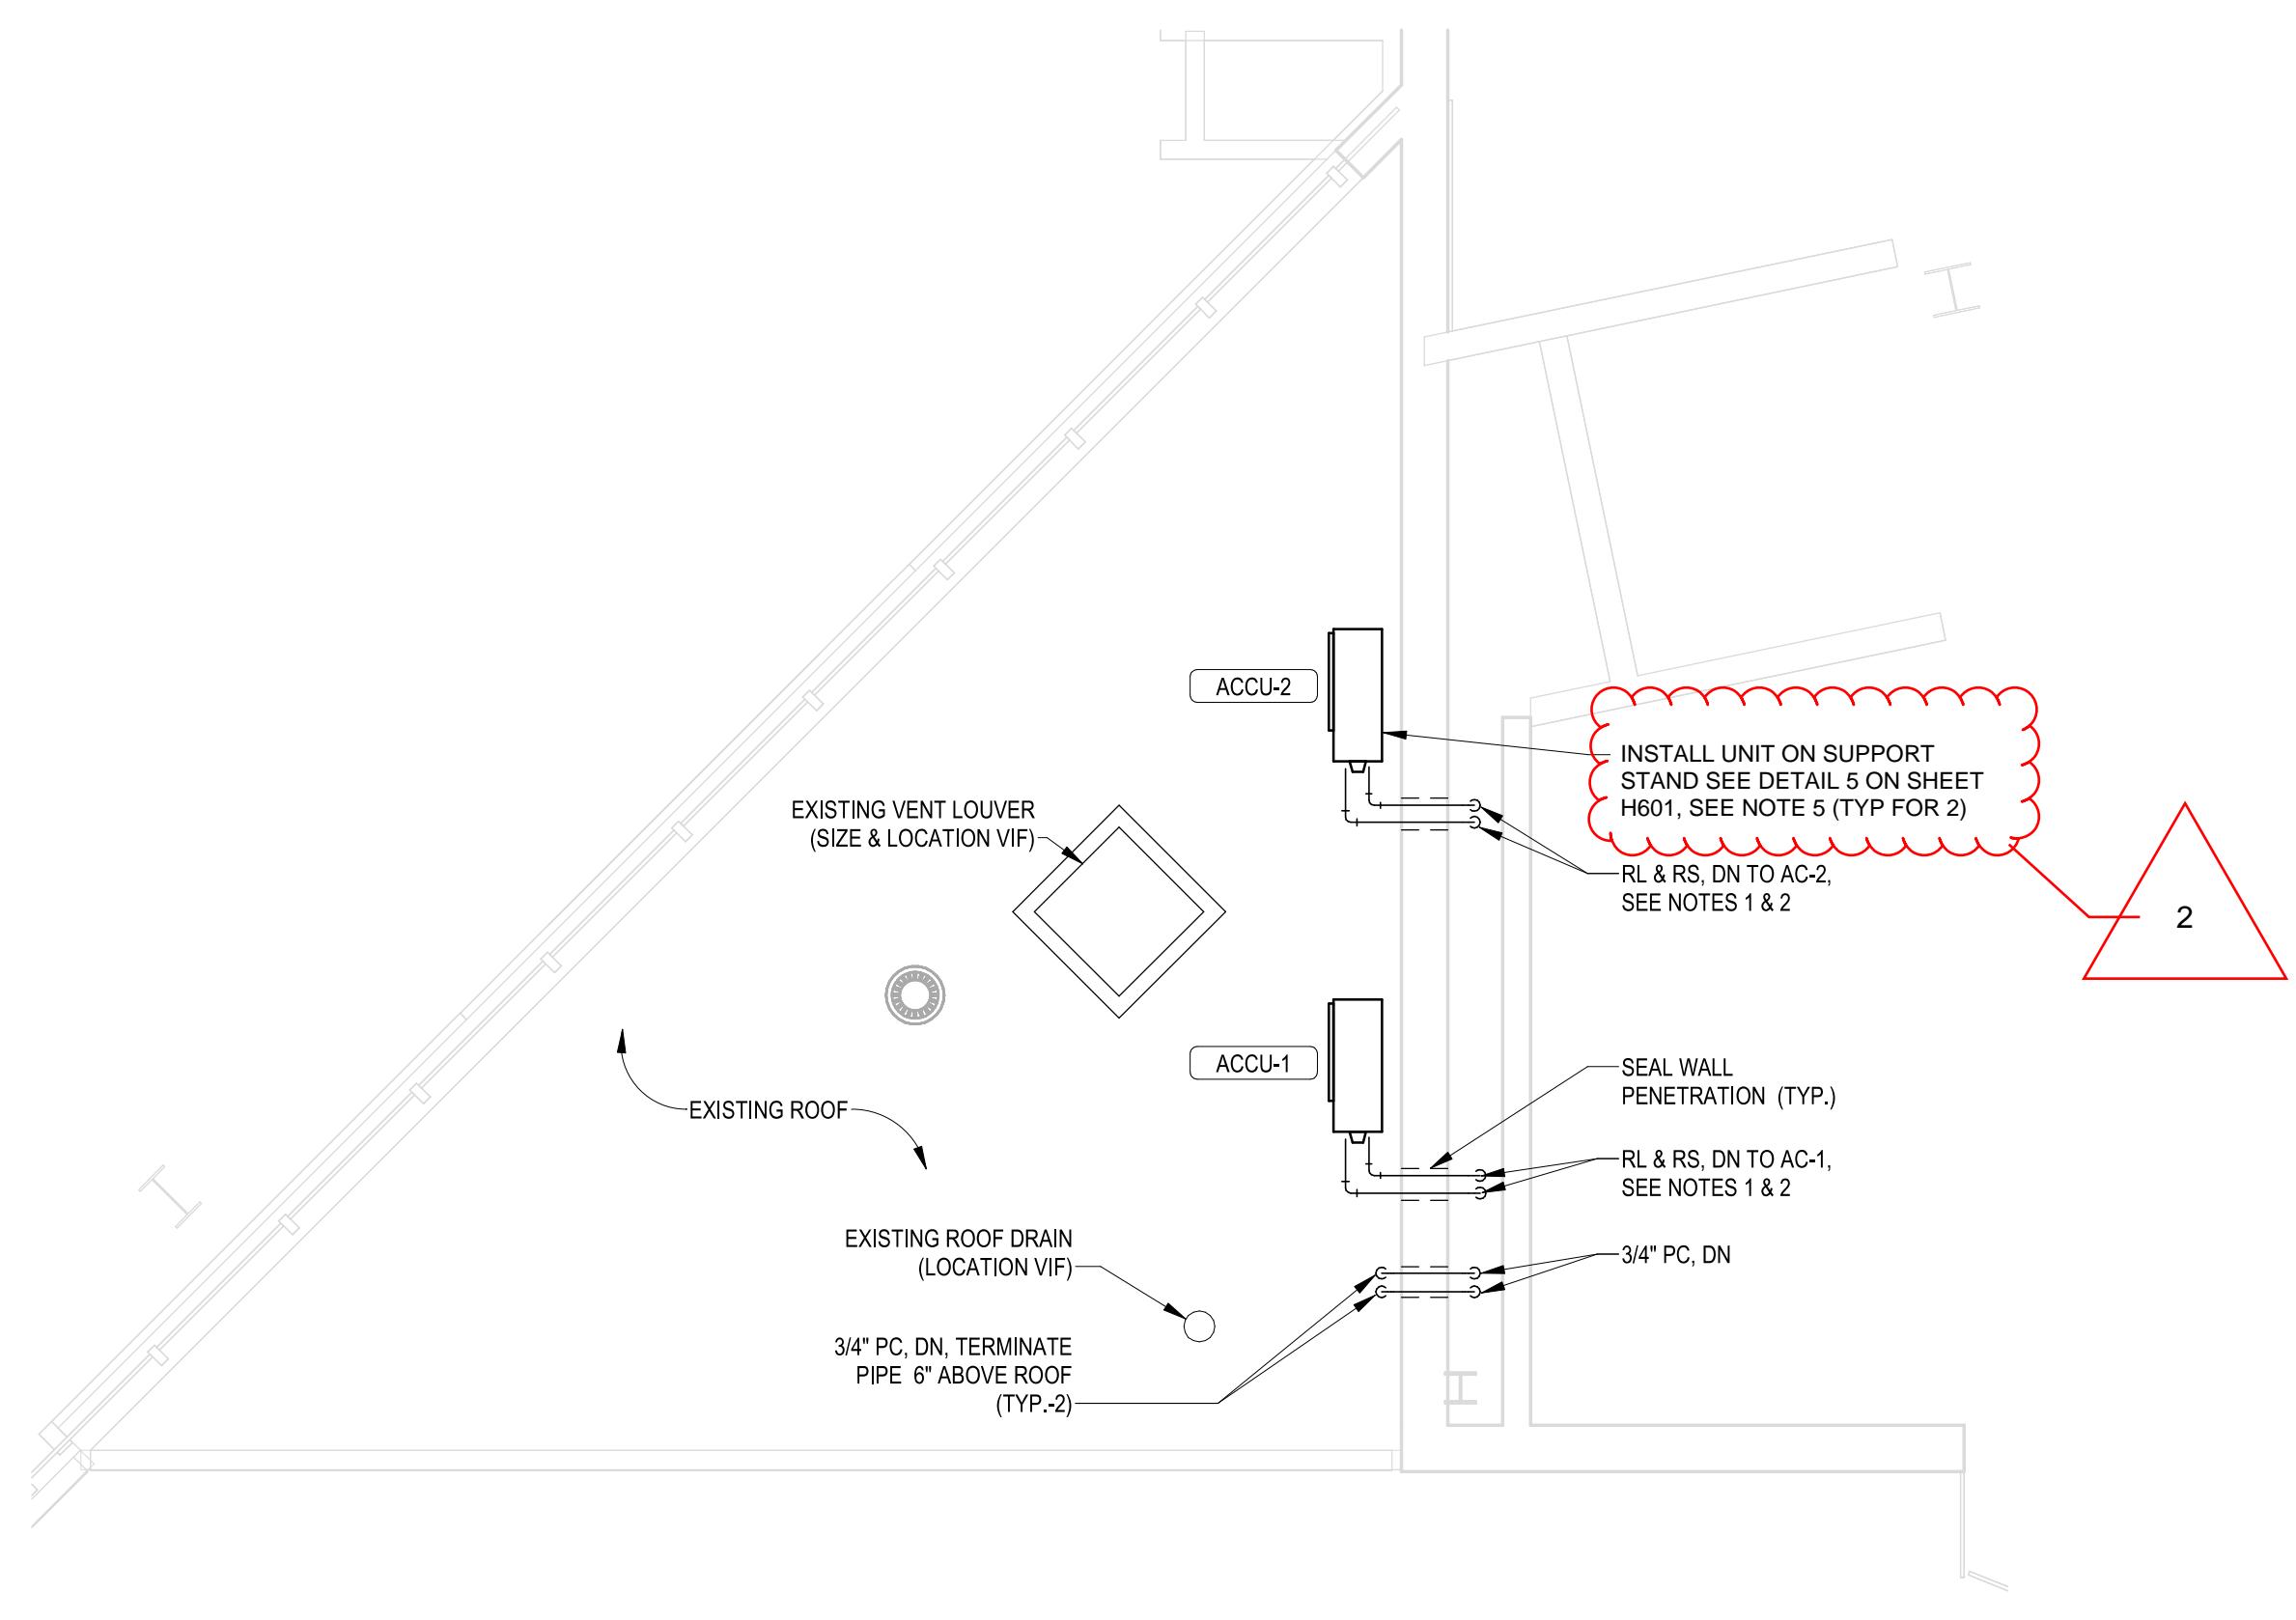

③ LOW ROOF PART PLAN - HVAC  
1/4" = 1'-0"

Revisions:

No. 2	Date 12/8/2025	Description new ACCU Mounted location on roof
-------	----------------	---

COA:

Seal:

Issued For:

BID DOCUMENTS

Scale: 1/4" = 1'-0"

Key Plan:

Date: NOVEMBER 2025  
Drawn By: YK  
Reviewed By: SEH  
Approved By: AAH  
W&S Project No.: ENG25-0990  
W&S File No.: XXX

Drawing Title: FIRST FLOOR AND ROOF PART PLANS

Sheet Number: H101

0 2' 4' 8'



Revisions:

No.	Date	Description
2	12/8/2025	new ACCU Mounted location on roof

COA:



Issued For:


BID DOCUMENTS

Scale: NTS

Key Plan:





Date: NOVEMBER 2025  
Drawn By: YK  
Reviewed By: SEH  
Approved By: AAH  
W&S Project No.: ENG25-0990  
W&S File No.: XXX

Drawing Title: HVAC DETAILS AND AUTOMATIC TEMPERATURE CONTROLS  
Sheet Number: H601

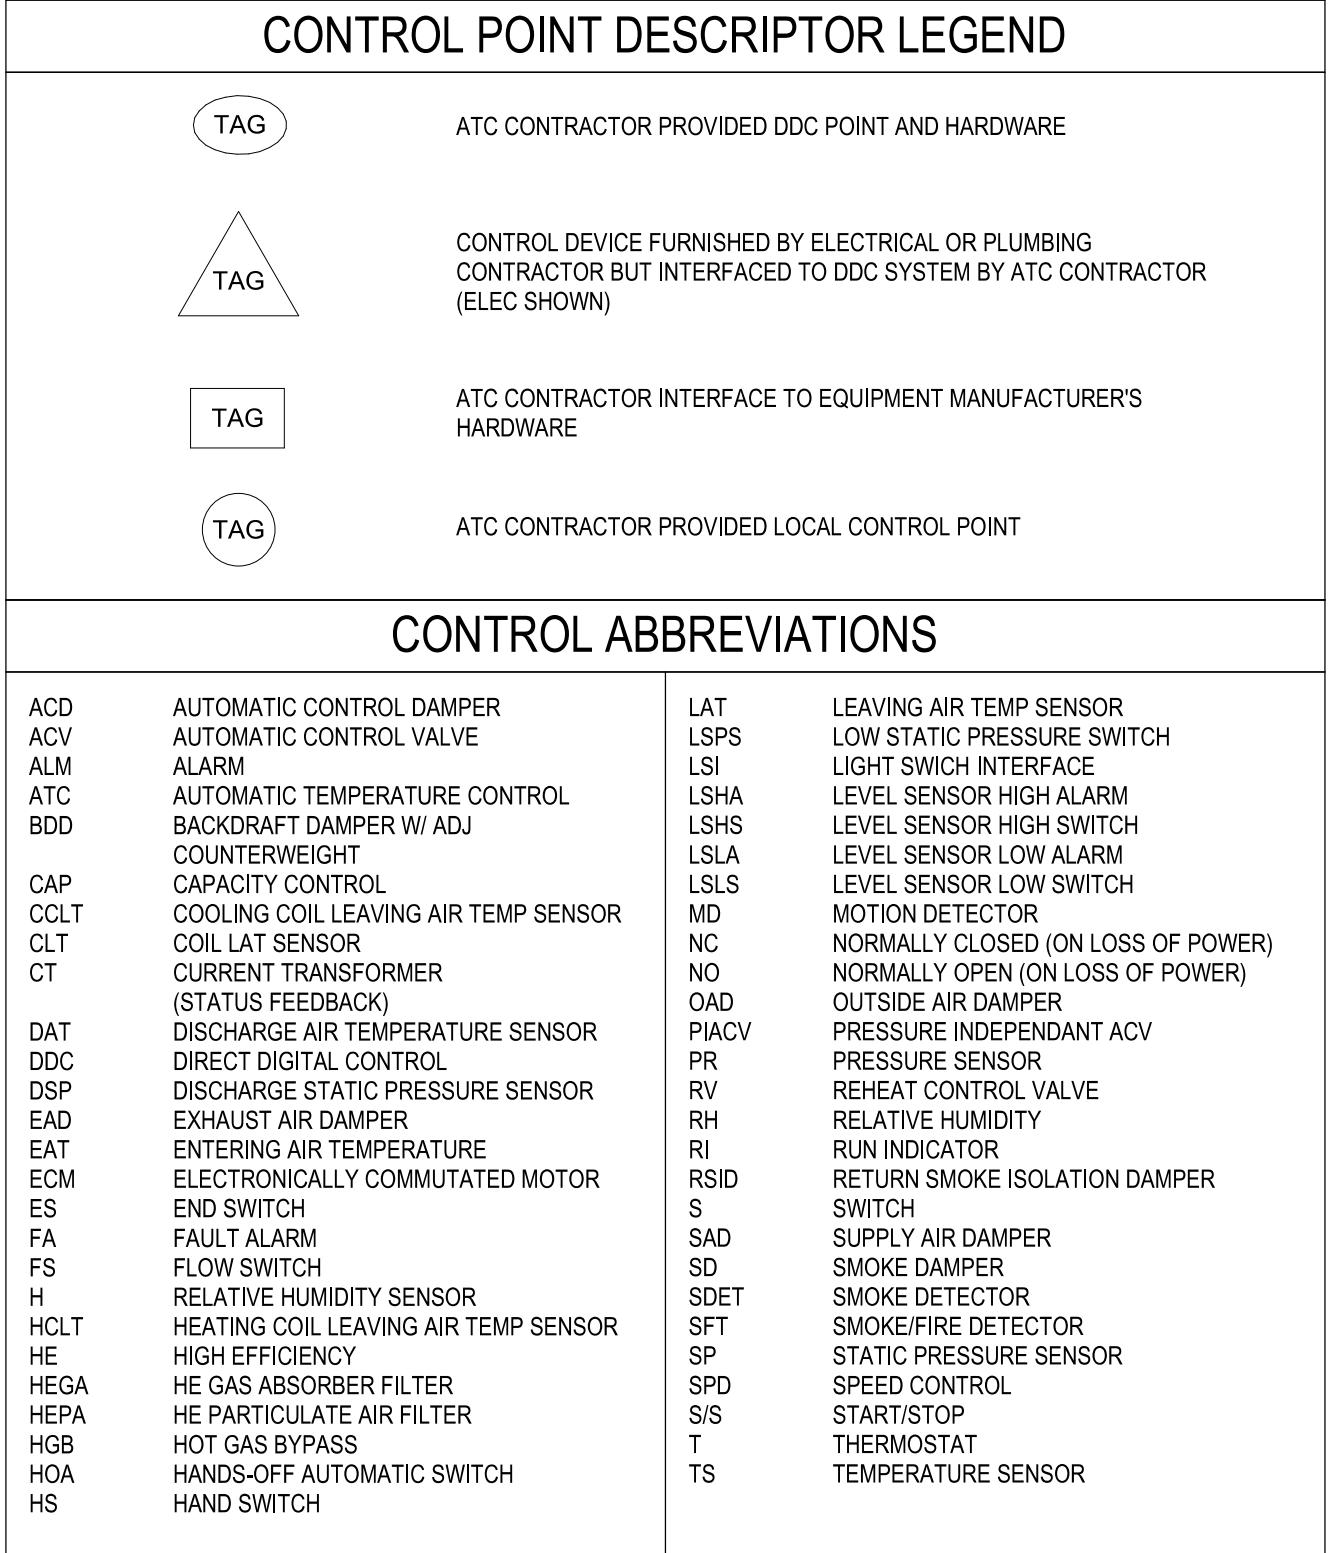

**GENERAL ATC NOTES**

- REFER TO SPECIFICATIONS FOR ADDITIONAL DETAILS AND REQUIREMENTS.
- ON-SITE TRAINING SHALL INCLUDE A MINIMUM OF 4 HOURS OF HANDS ON INSTRUCTION GEARED TOWARD OPERATION AND MAINTENANCE OF THE SYSTEMS. PRIOR TO TRAINING, THE NECESSARY LESSON PLANS, TRAINING DOCUMENTS, HANDOUTS, ETC. SHALL BE PROVIDED WITH THE CURRICULUM OUTLINED.
- ALL TRAINING SHALL BE RECORDED AND COPIED TO DVD BY THE ATC CONTRACTOR. THREE COPIES OF THE RECORDED SESSIONS SHALL BE SUBMITTED TO THE OWNER FOR THEIR USE.
- PROVIDE WIRING FROM ELECTRICAL SOURCE TO MISCELLANEOUS ATC DEVICES. REFER TO HVAC PLANS, HVAC MECHANICAL ROOM PLANS, AND ELECTRICAL PLANS FOR LOCATION OF POWER SOURCES FOR ATC SYSTEM.
- PROVIDE DEMOLITION OF EXISTING CONTROL COMPONENTS WHICH ARE BEING REPLACED BY THE NEW ATC CONTROL SYSTEM.
- ALL ATC CONTROLS SHALL BE HARDWIRED. NO WIRELESS TECHNOLOGY SHALL BE ALLOWED. ALL EXPOSED WIRING IN THE SHOPS, MAINTENANCE OR STORAGE AREAS SHALL BE INSTALLED IN MINIMUM 1/2 INCH GALVANIZED EMT CONDUIT. ALL EXPOSED WIRING IN A CLASS 1 DIVISION 1 SPACE SHALL BE INSTALLED IN MINIMUM 1/2" PVC COATED RIGID STEEL.
- INSTALL ALL NEW CONTROL WIRING FOR OCCUPIED SPACES IN THE WALLS. WHERE WIRING WOULD BE EXPOSED IN THESE AREAS, THE WIRING SHALL BE INSTALLED IN WIRE MOLD.

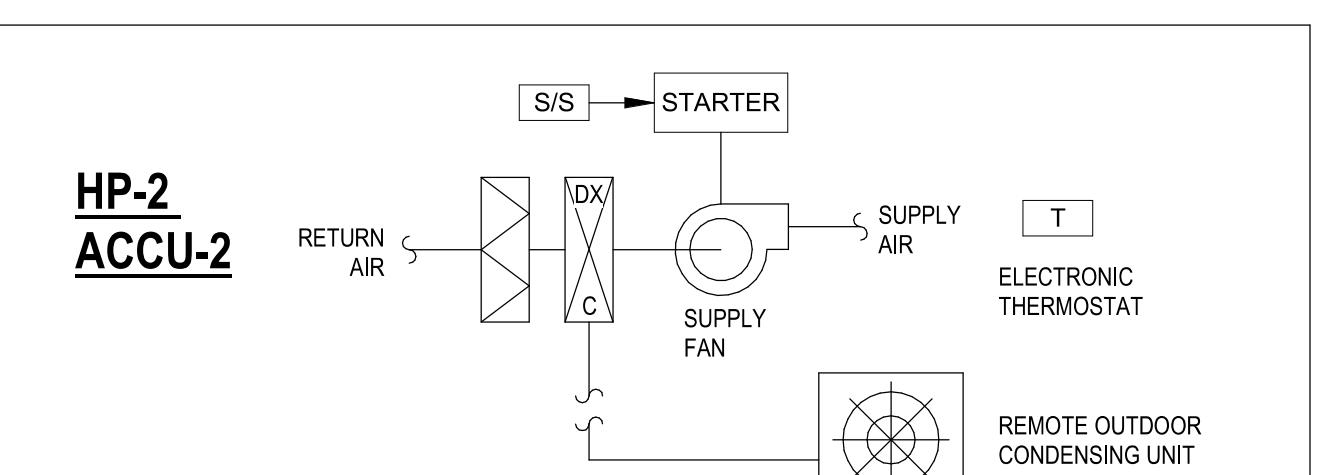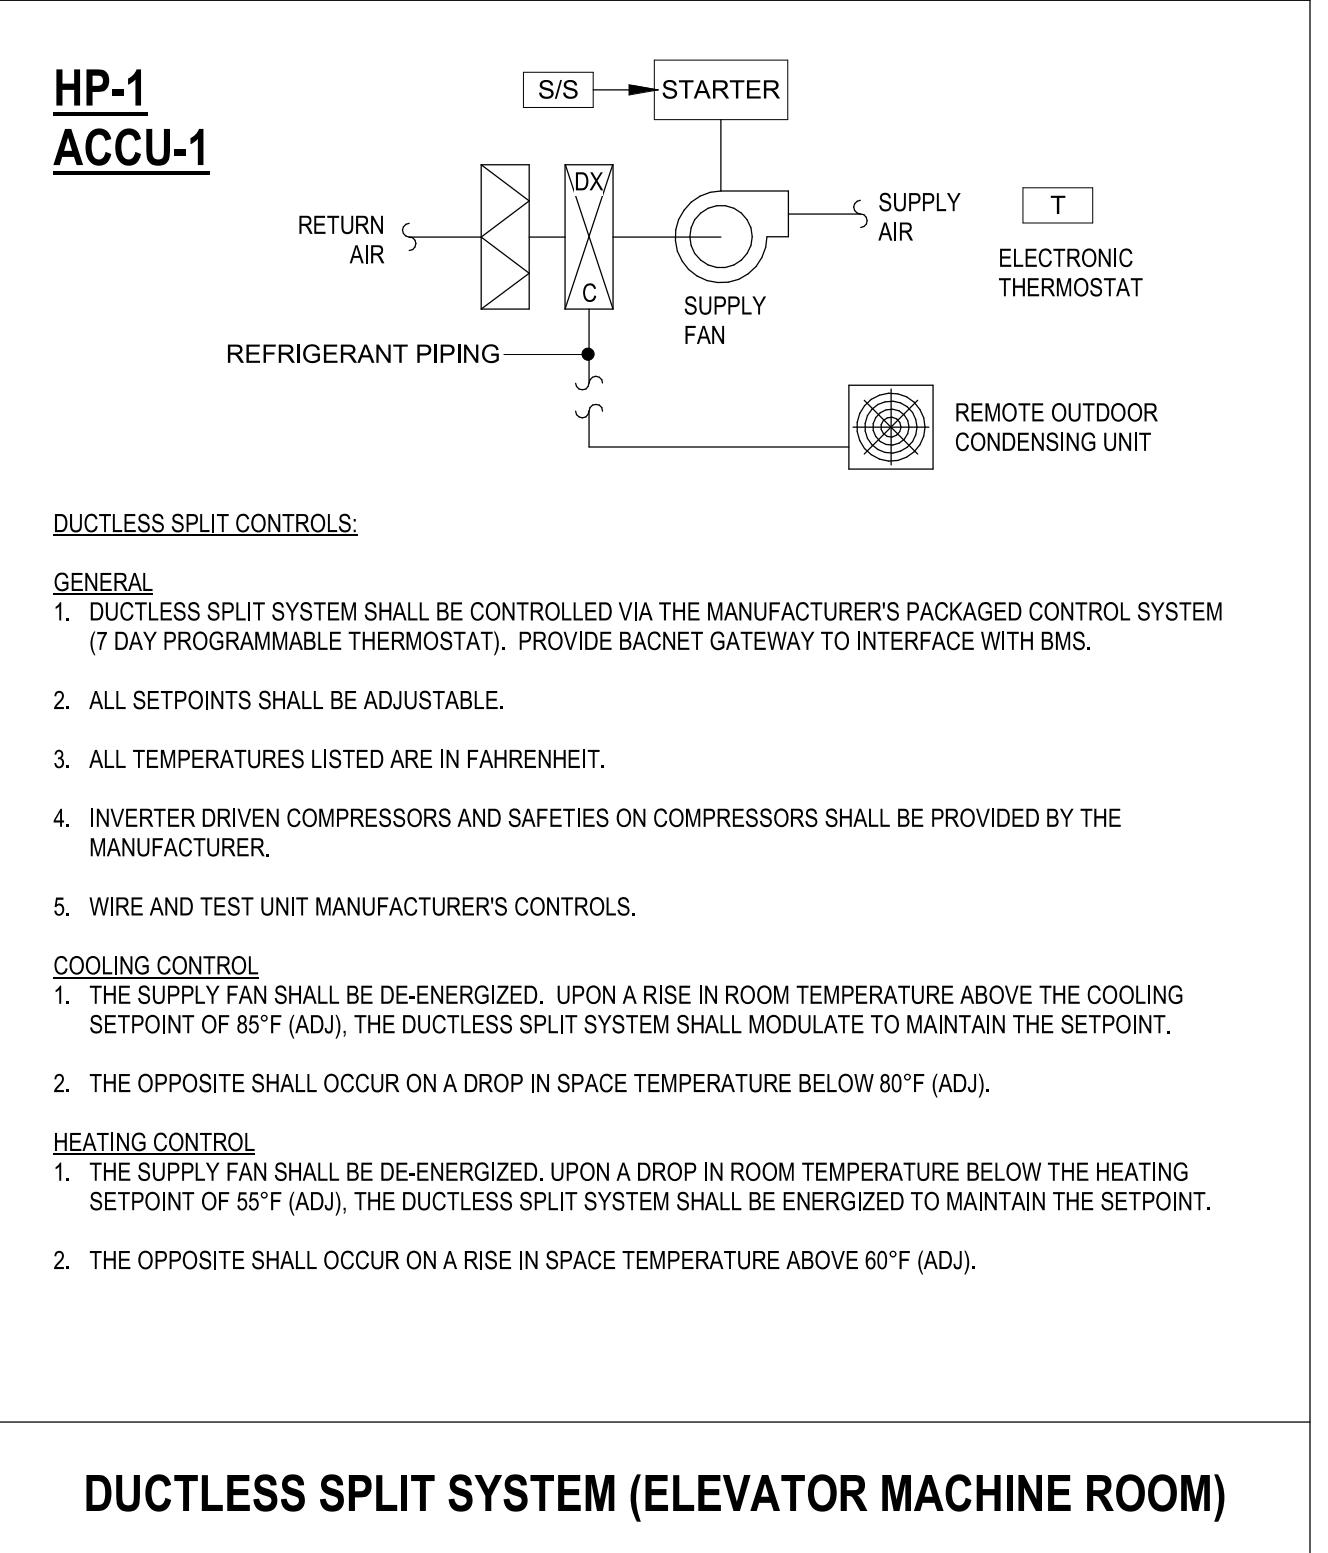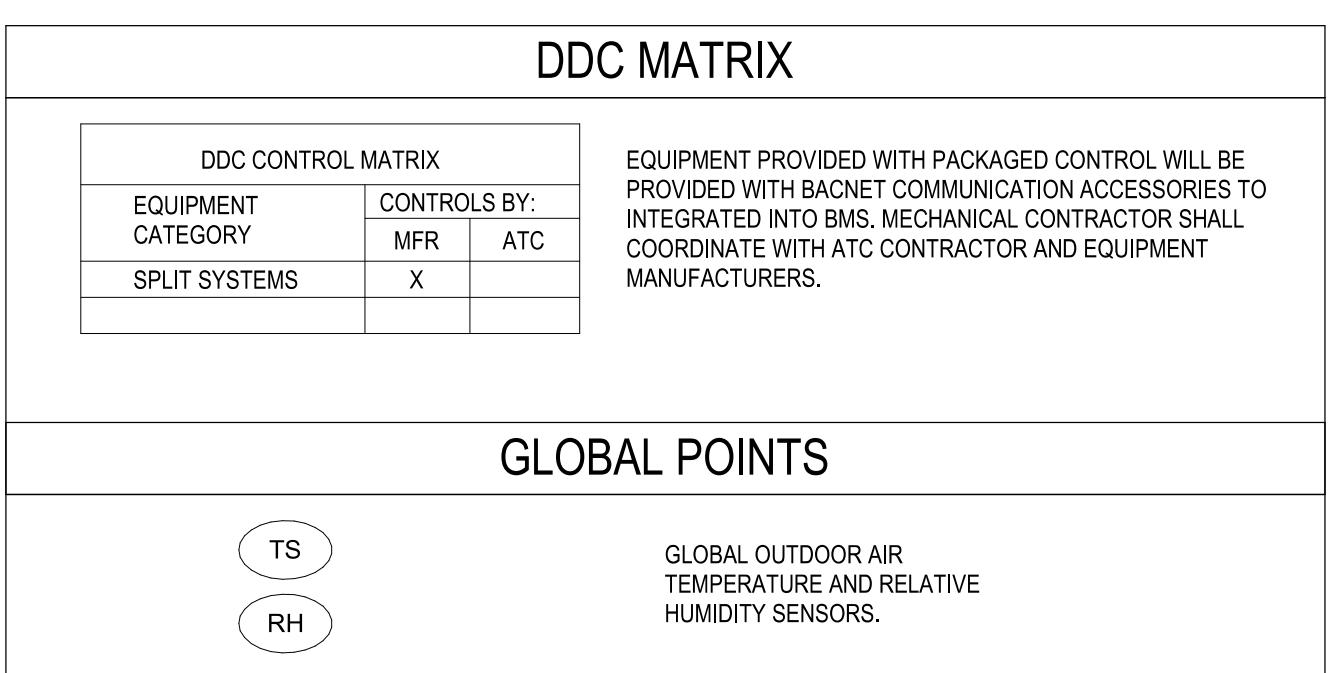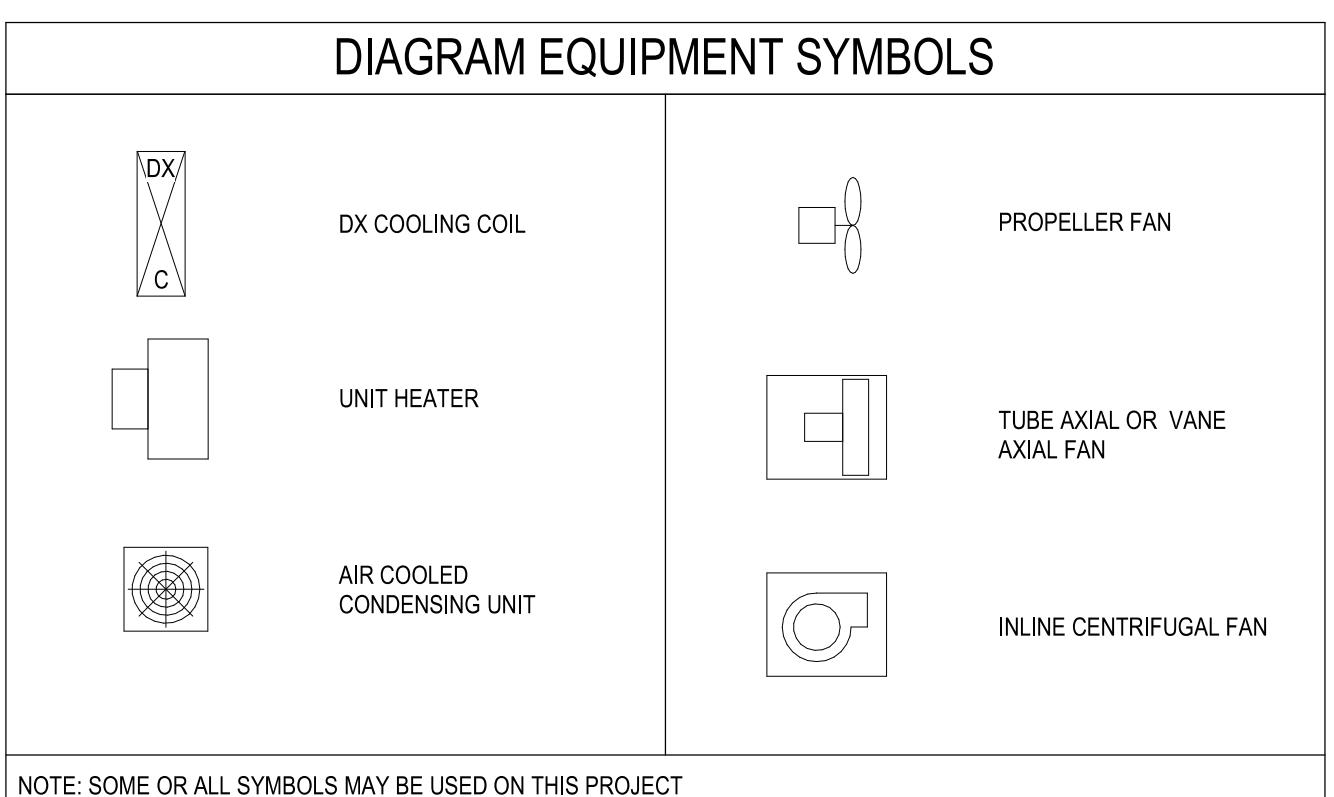

**DUCTLESS SPLIT CONTROLS:**

**GENERAL**

- DUCTLESS SPLIT SYSTEM SHALL BE CONTROLLED VIA THE MANUFACTURER'S PACKAGED CONTROL SYSTEM (7 DAY PROGRAMMABLE THERMOSTAT).
- COORDINATE OCCUPIED AND UNOCCUPIED SCHEDULES WITH THE OWNER.
- ALL SETPOINTS SHALL BE ADJUSTABLE.
- ALL TEMPERATURES LISTED ARE IN FAHRENHEIT.
- INVERTER DRIVEN COMPRESSORS AND SAFETIES ON COMPRESSORS SHALL BE PROVIDED BY THE MANUFACTURER.
- WIRE AND TEST UNIT MANUFACTURER'S CONTROLS.

**COOLING CONTROL**

- THE SUPPLY FAN SHALL BE DE-ENERGIZED. UPON A RISE IN ROOM TEMPERATURE ABOVE THE COOLING SETPOINT OF 78°F (ADJ), THE DUCTLESS SPLIT SYSTEM SHALL BE ENERGIZED TO MAINTAIN THE SETPOINT.
- THE OPPOSITE SHALL OCCUR ON A DROP IN SPACE TEMPERATURE BELOW 74°F (ADJ).

**HEATING CONTROL**

- THE SUPPLY FAN SHALL BE DE-ENERGIZED. UPON A DROP IN ROOM TEMPERATURE BELOW THE HEATING SETPOINT OF 68°F (ADJ), THE DUCTLESS SPLIT SYSTEM SHALL BE ENERGIZED TO MAINTAIN THE SETPOINT.
- THE OPPOSITE SHALL OCCUR ON A RISE IN SPACE TEMPERATURE ABOVE 72°F (ADJ).

**DUCTLESS SPLIT SYSTEM (EMPLOYEE ENTRY)**

